

MALON D MIMMS CO
 85-A MILL ST.
 ROSWELL, GA 30075
 770-518-1100

RONIN
 DESIGN GROUP, INC

6075 ROSWELL RD, NE
 SUITE 118
 ATLANTA, GA 30328

404-705-8450 PHONE
 404-705-8449 FAX

PLAN:

**COLUMBIA
 NORTHEAST SC**

SUITE 40
 9221 TWO NOTCH RD
 COLUMBIA, SC
 29223

DETAIL:

**AS-BUILT
 LAYOUT**

DATE DRAWN:

MAY 13, 2008

SCALE:


AS SHOWN

JOB NO:

SHEET:

A-1

1 OF SHEETS 1

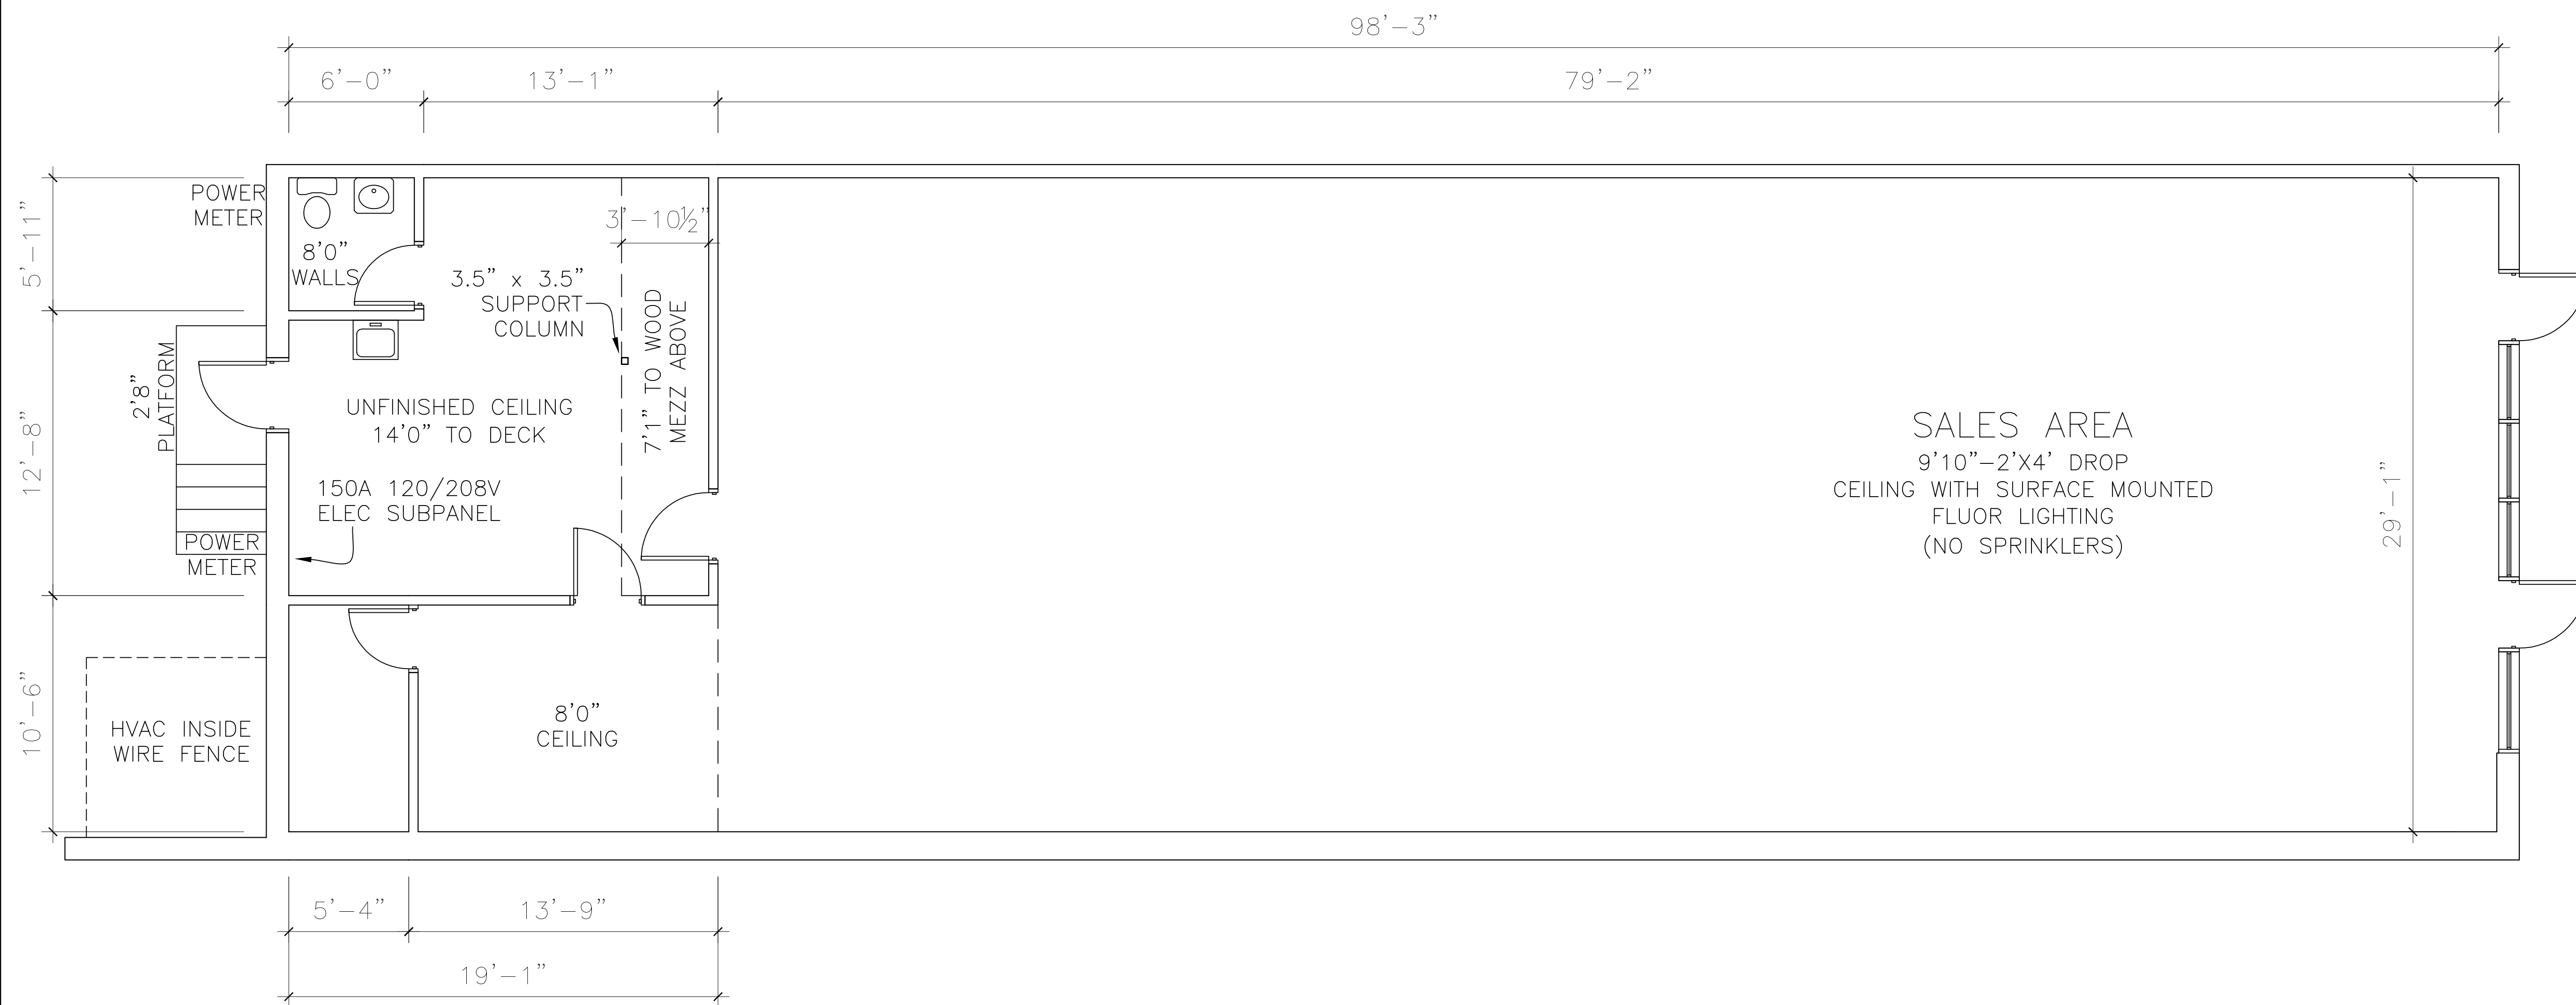

EXISTING FLOOR PLAN:
 SCALE: 1/4" = 1'-0"

NOTE: DIMENSIONS ARE FOR INTERIOR REFERENCE ONLY,
 AND DO NOT REFLECT TOTAL SUITE SQUARE FOOTAGE.