

MALON D MIMMS CO  
 85-A MILL ST.  
 ROSWELL, GA 30075  
 770-518-1100

**RONIN**  
 DESIGN GROUP, INC

6075 ROSWELL RD, NE  
 SUITE 118  
 ATLANTA, GA 30328

404-705-8450 PHONE  
 404-705-8449 FAX

PLAN:

**COLUMBIA  
 NORTHEAST SC**

SUITE 9219  
 9219 TWO NOTCH RD  
 COLUMBIA, SC  
 29223

DETAIL:

**AS-BUILT  
 LAYOUT**

DATE DRAWN:

MAY 12, 2008

SCALE:


AS SHOWN

JOB NO:

SHEET:

**A-1**

1 OF SHEETS 1

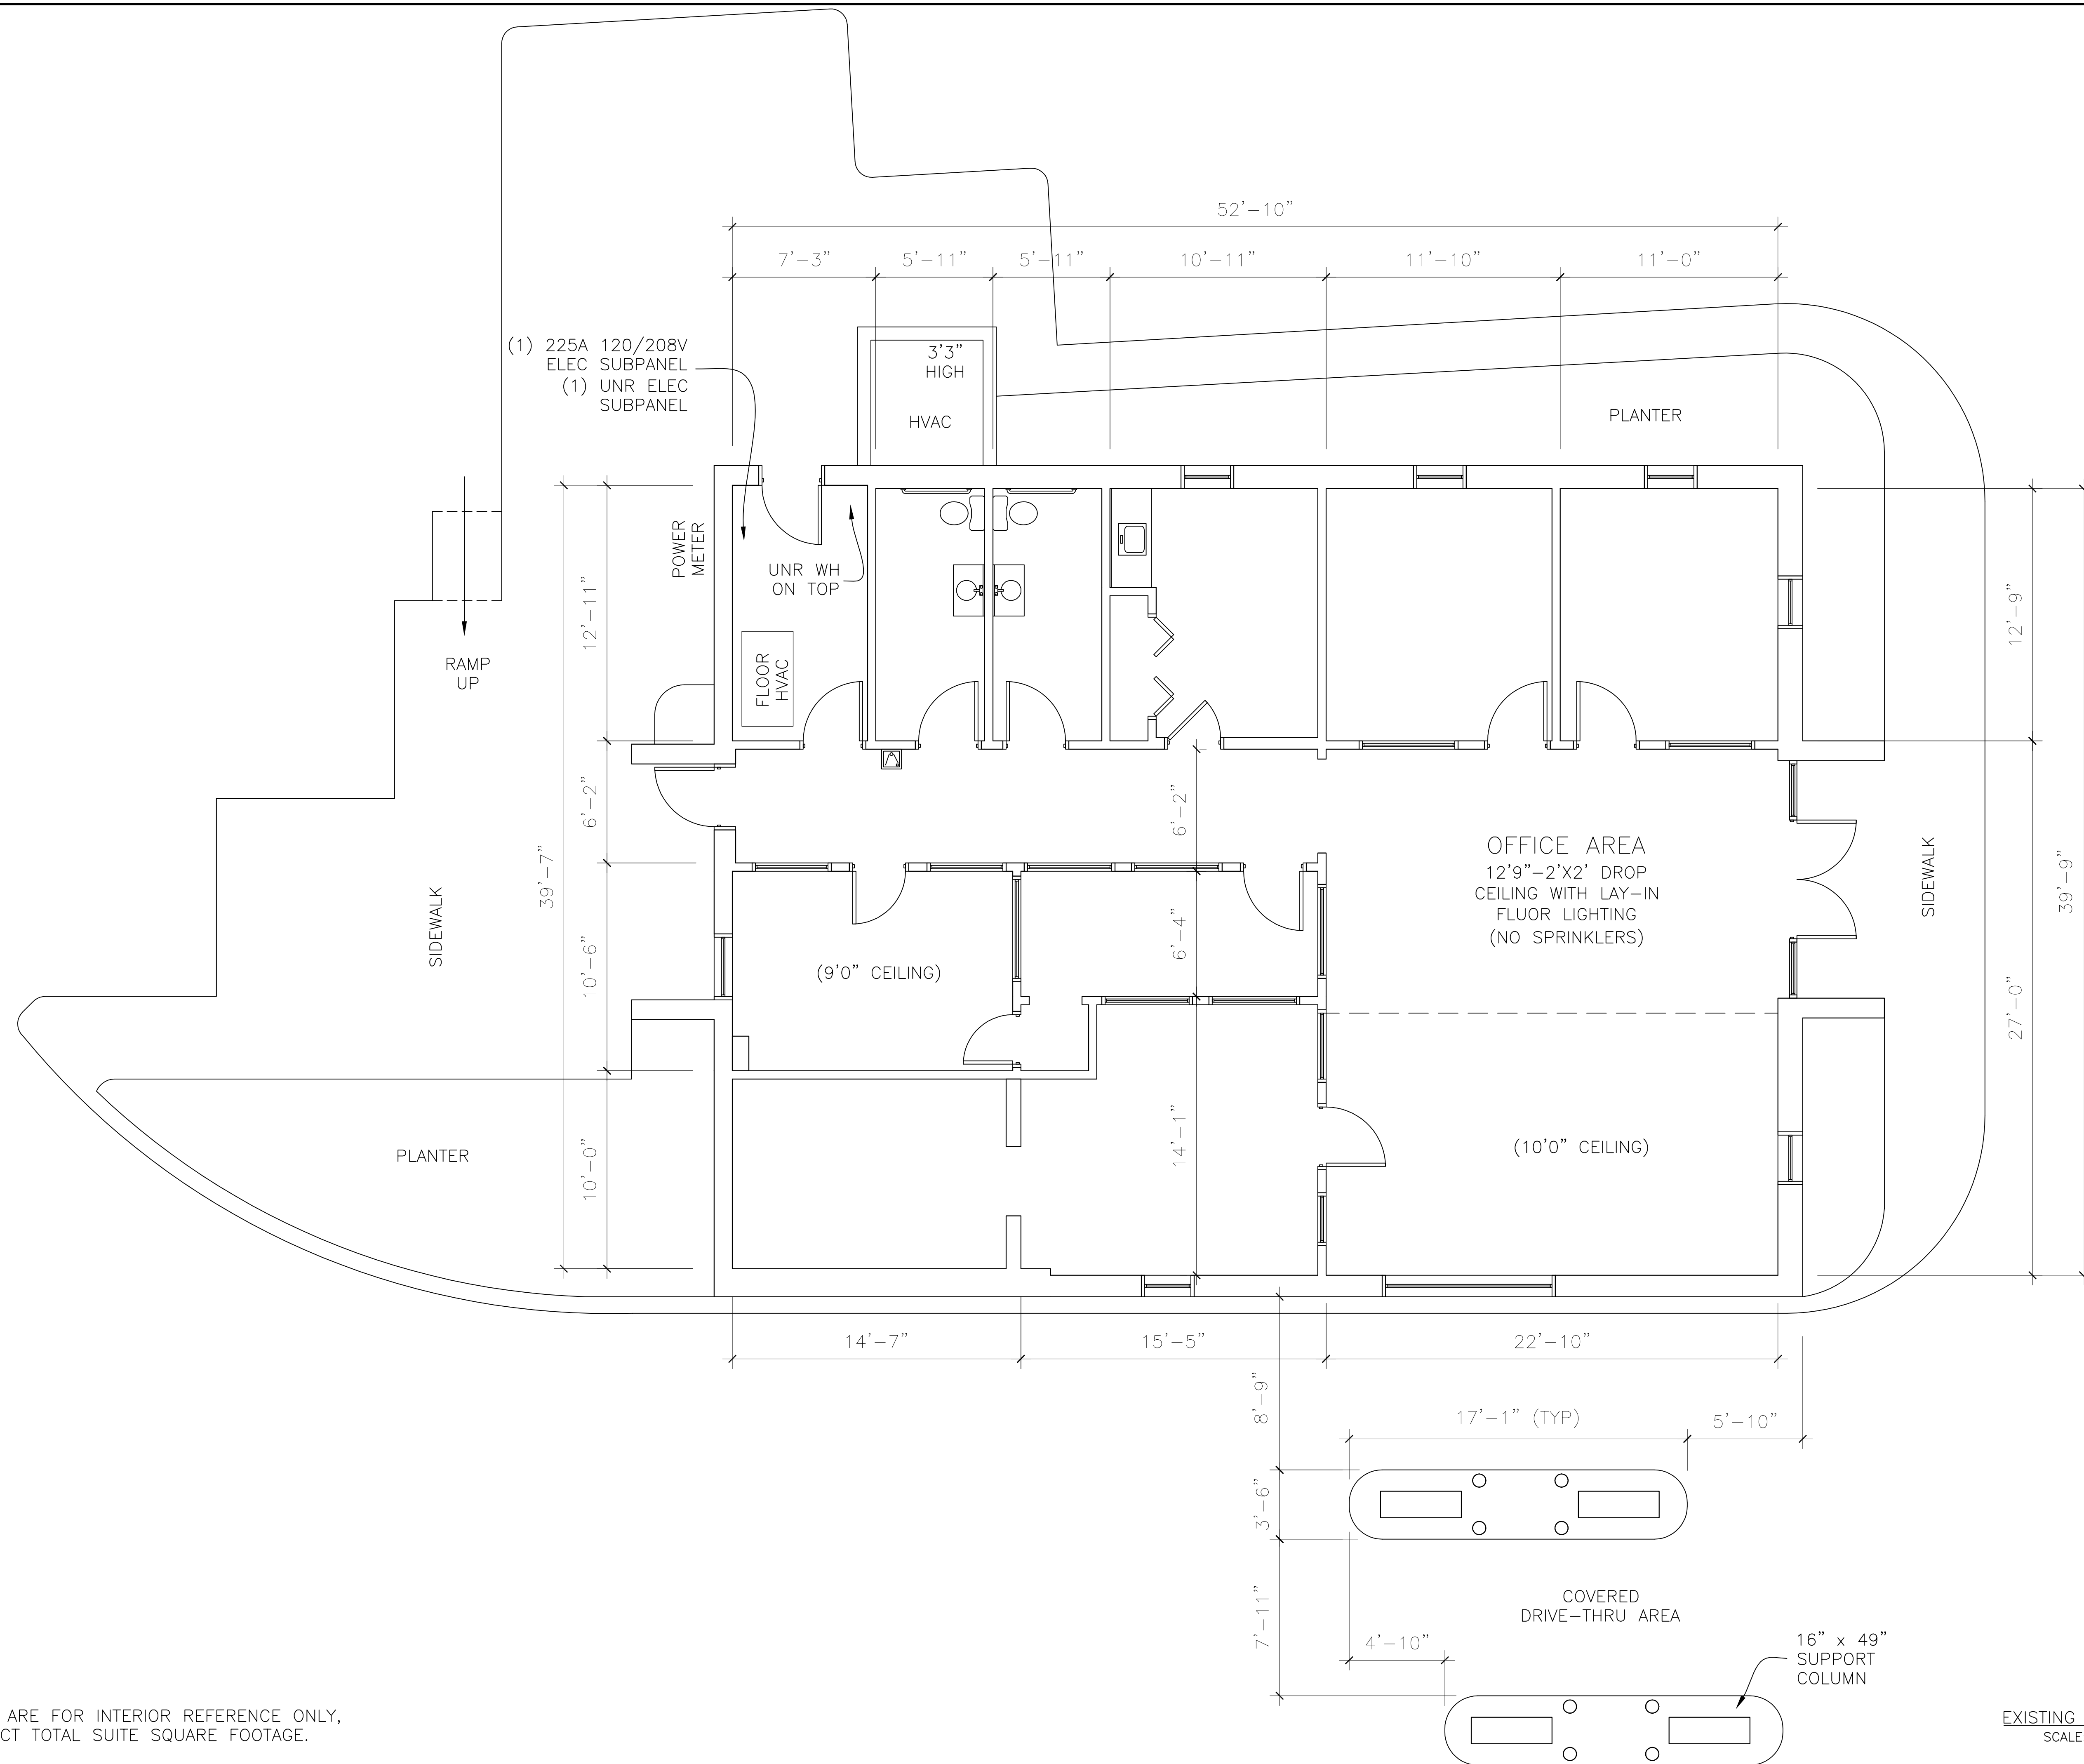

NOTE: DIMENSIONS ARE FOR INTERIOR REFERENCE ONLY,  
 AND DO NOT REFLECT TOTAL SUITE SQUARE FOOTAGE.

EXISTING FLOOR PLAN:  
 SCALE: 1/4" = 1'-0"