


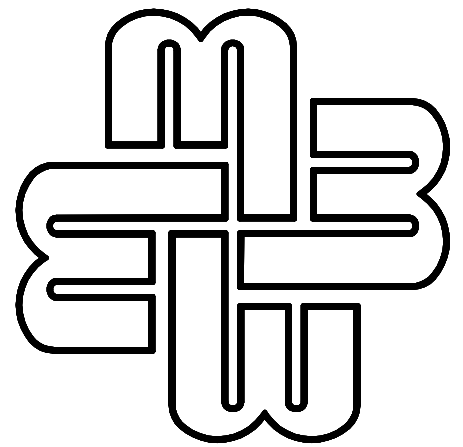

MALON D MIMMS CO
85-A MILL ST.
ROSWELL, GA 30075
770-518-1100



6075 ROSWELL RD, NE
SUITE 118
ATLANTA, GA 30328

404-705-8450 PHONE
404-705-8449 FAX


PLAN:
**COLUMBIA
NORTHEAST SC**
SUITE 80
9221 TWO NOTCH RD
COLUMBIA, SC
29223

DETAIL:
**AS-BUILT
LAYOUT**

DATE DRAWN:
MAY 12, 2008
SCALE:
AS SHOWN

JOB NO:

SHEET:
A-1
1 OF SHEETS 1

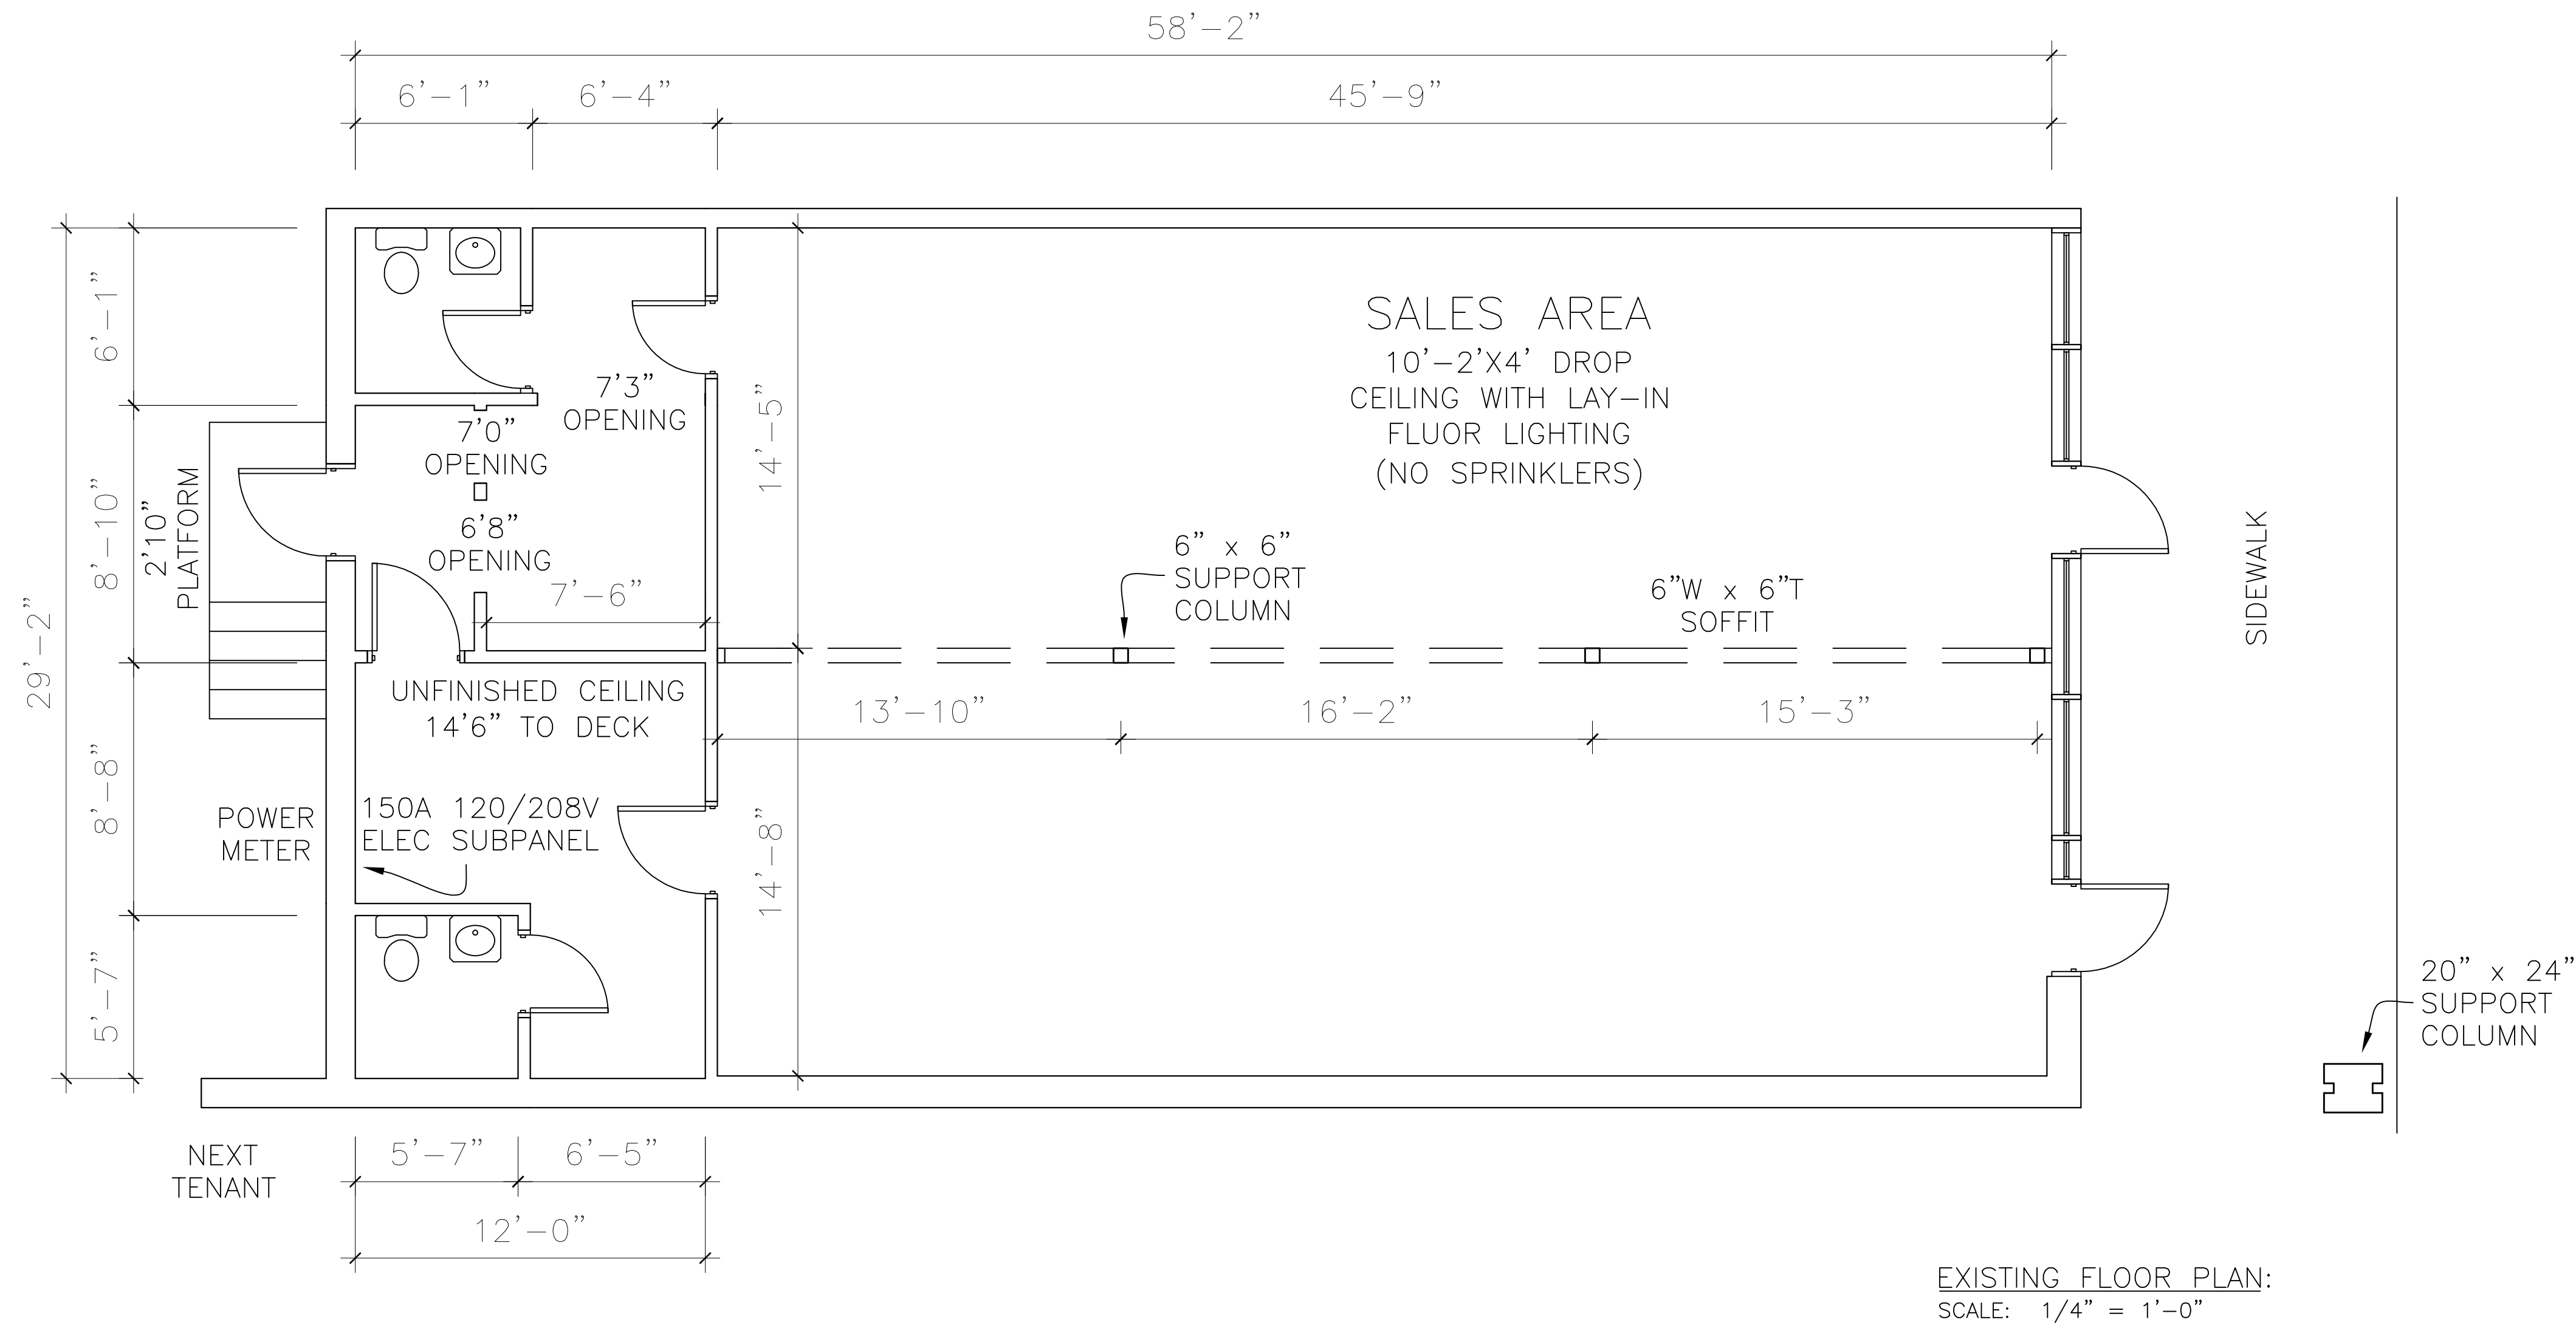

EXISTING FLOOR PLAN:
SCALE: 1/4" = 1'-0"

NOTE: DIMENSIONS ARE FOR INTERIOR REFERENCE ONLY,
AND DO NOT REFLECT TOTAL SUITE SQUARE FOOTAGE.