


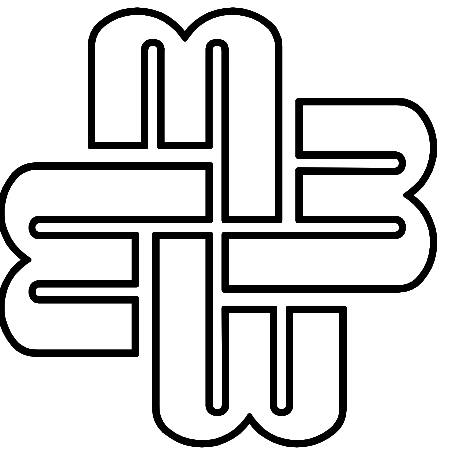

MALON D MIMMS CO
85-A MILL ST.
ROSWELL, GA 30075
770-518-1100

RONIN
DESIGN GROUP, INC

6075 ROSWELL RD, NE
SUITE 118
ATLANTA, GA 30328

404-705-8450 PHONE
404-705-8449 FAX

PLAN:

**LEESBURG
VILLAGE**

SUITE 60
2900 LEESBURG RD.
COLUMBIA, SC
29209

DETAIL:

**AS-BUILT
LAYOUT**

DATE DRAWN:

MAY 12, 2008

SCALE:

AS SHOWN


JOB NO:

SHEET:

A-1

1 OF

SHEETS 1

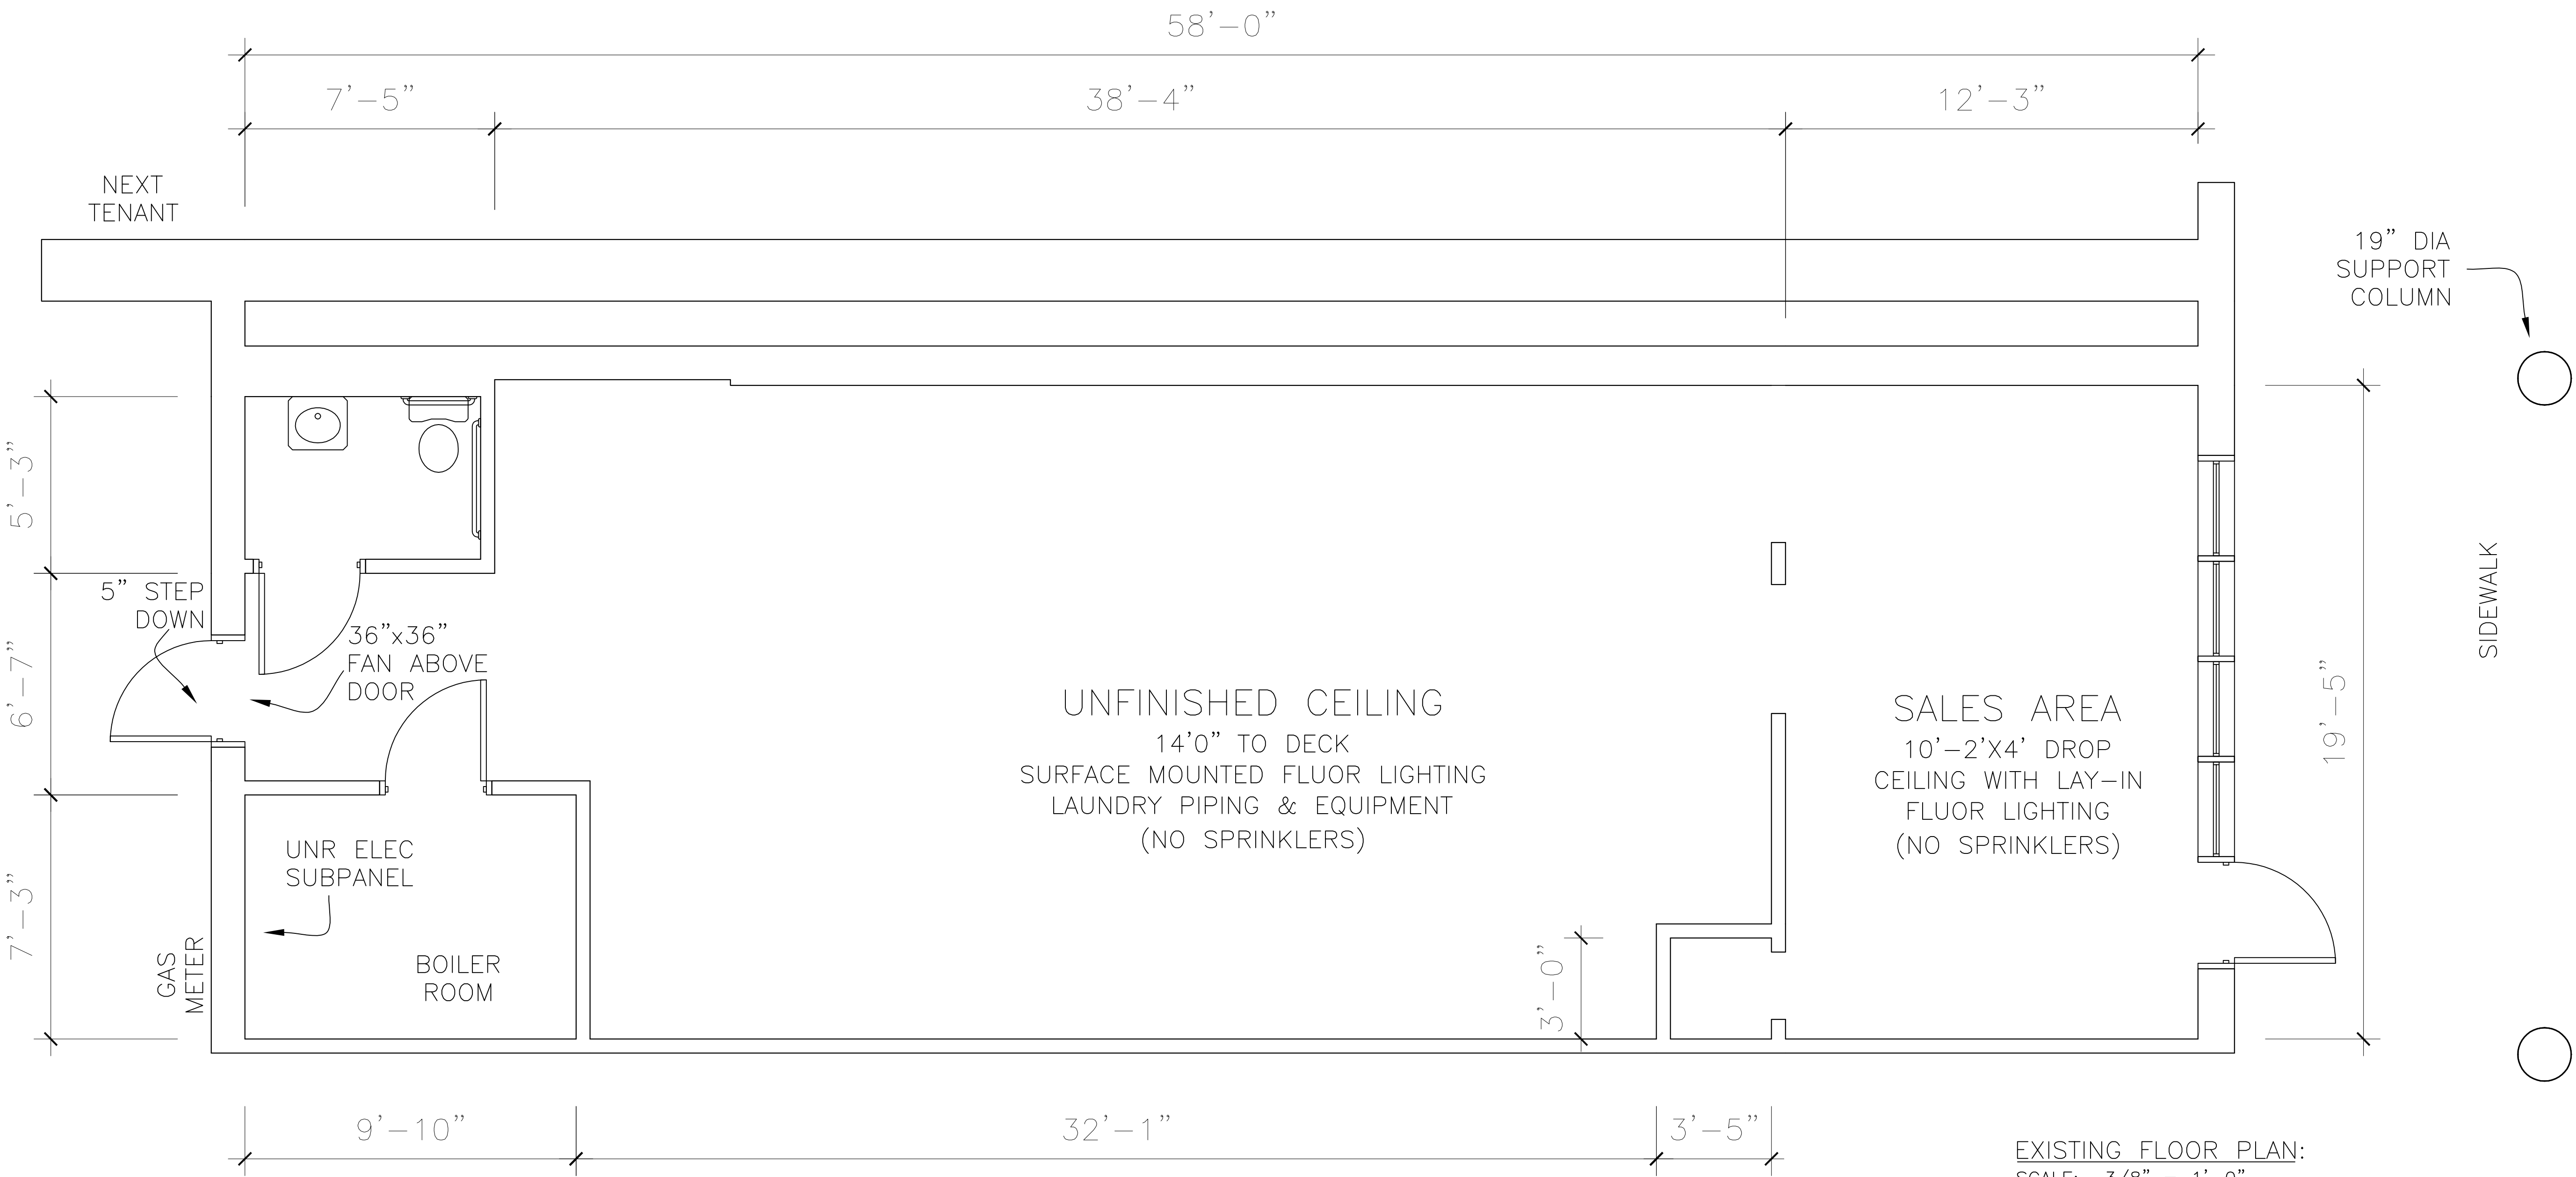

NOTE: DIMENSIONS ARE FOR INTERIOR REFERENCE ONLY,
AND DO NOT REFLECT TOTAL SUITE SQUARE FOOTAGE.

EXISTING FLOOR PLAN:
SCALE: 3/8" = 1'-0"