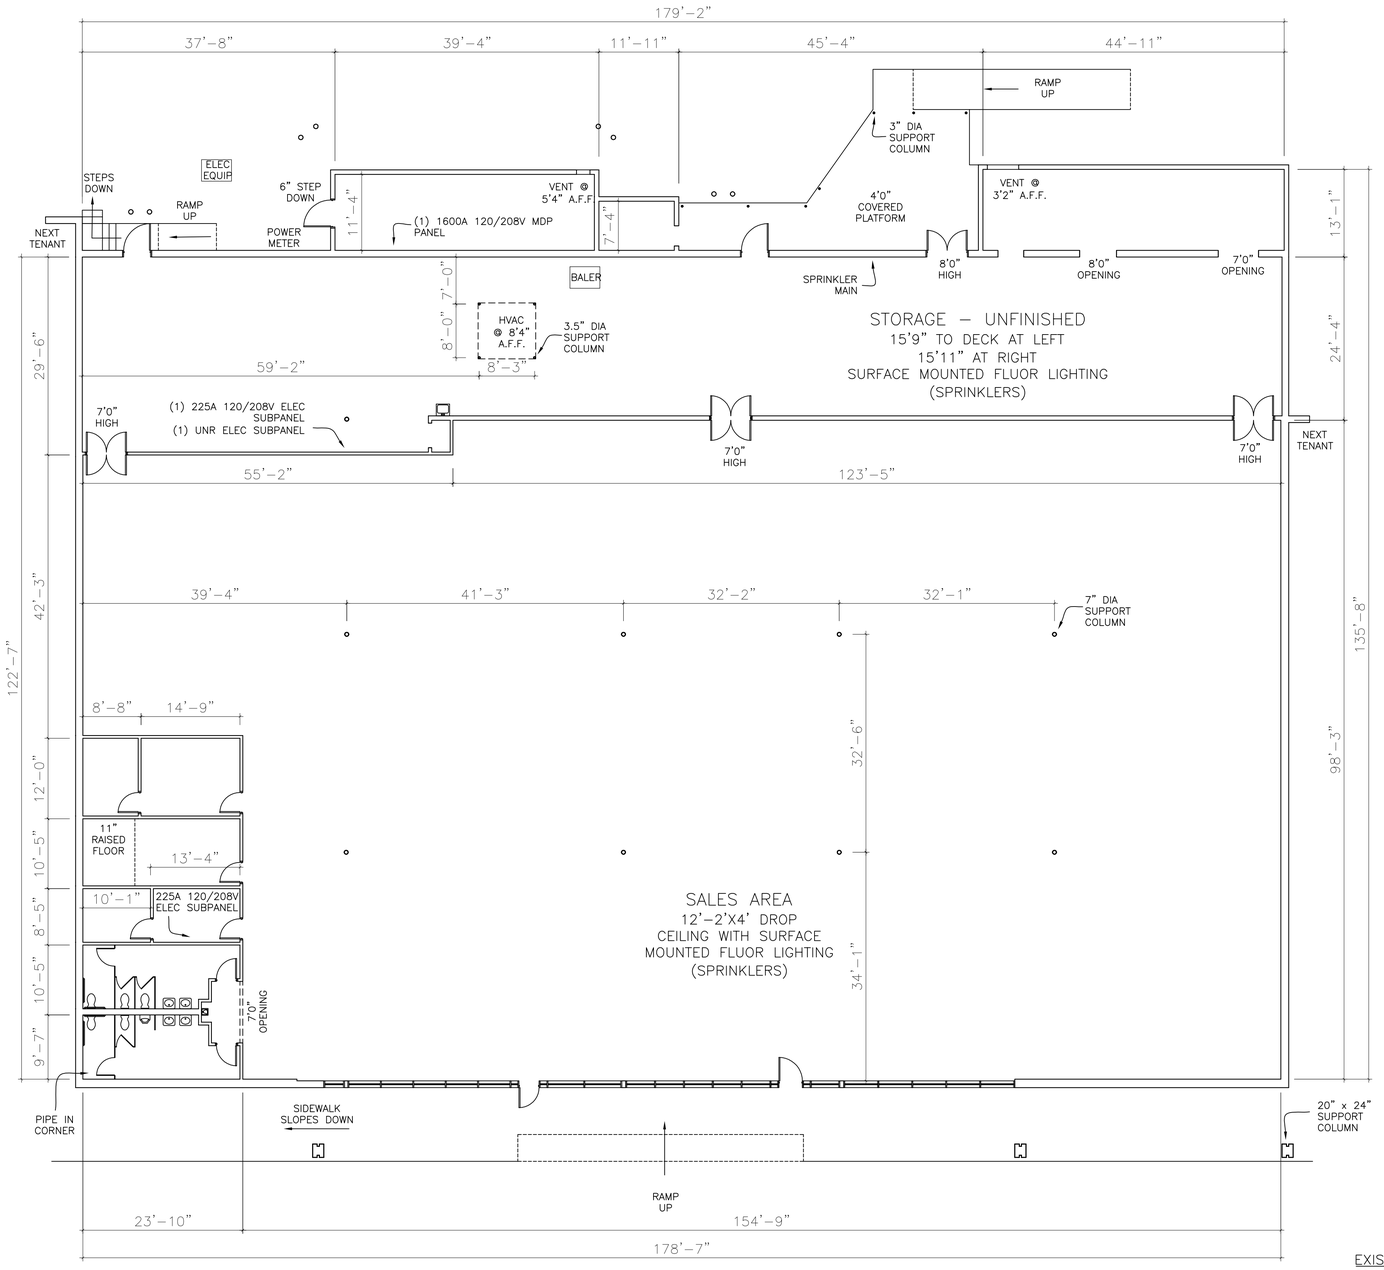

EXISTING FLOOR PLAN:
SCALE: 3/32" = 1'-0"

NOTE: DIMENSIONS ARE FOR INTERIOR REFERENCE ONLY,
AND DO NOT REFLECT TOTAL SUITE SQUARE FOOTAGE.

MALON D MIMMS CO
85-A MILL ST.
ROSWELL, GA 30075
770-518-1100

RONIN DESIGN GROUP, INC

6075 ROSWELL RD, NE
SUITE 118
ATLANTA, GA 30328

404-705-8450 PHONE
404-705-8449 FAX

PLAN:

COLUMBIA NORTHEAST SC

SUITE 30
9221 TWO NOTCH RD
COLUMBIA, SC
29223

DETAIL:

AS-BUILT LAYOUT

DATE DRAWN:

MAY 13, 2008

SCALE:

AS SHOWN

JOB NO:

SHEET:

A-1

1 OF SHEETS 1